


MANHATTAN PARK &  
OCTAGON  
COMFORT STATION  
Roosevelt Island,  
New York

August 2018

Preliminary Irrigation  
As-built

Scale 1" = 30'

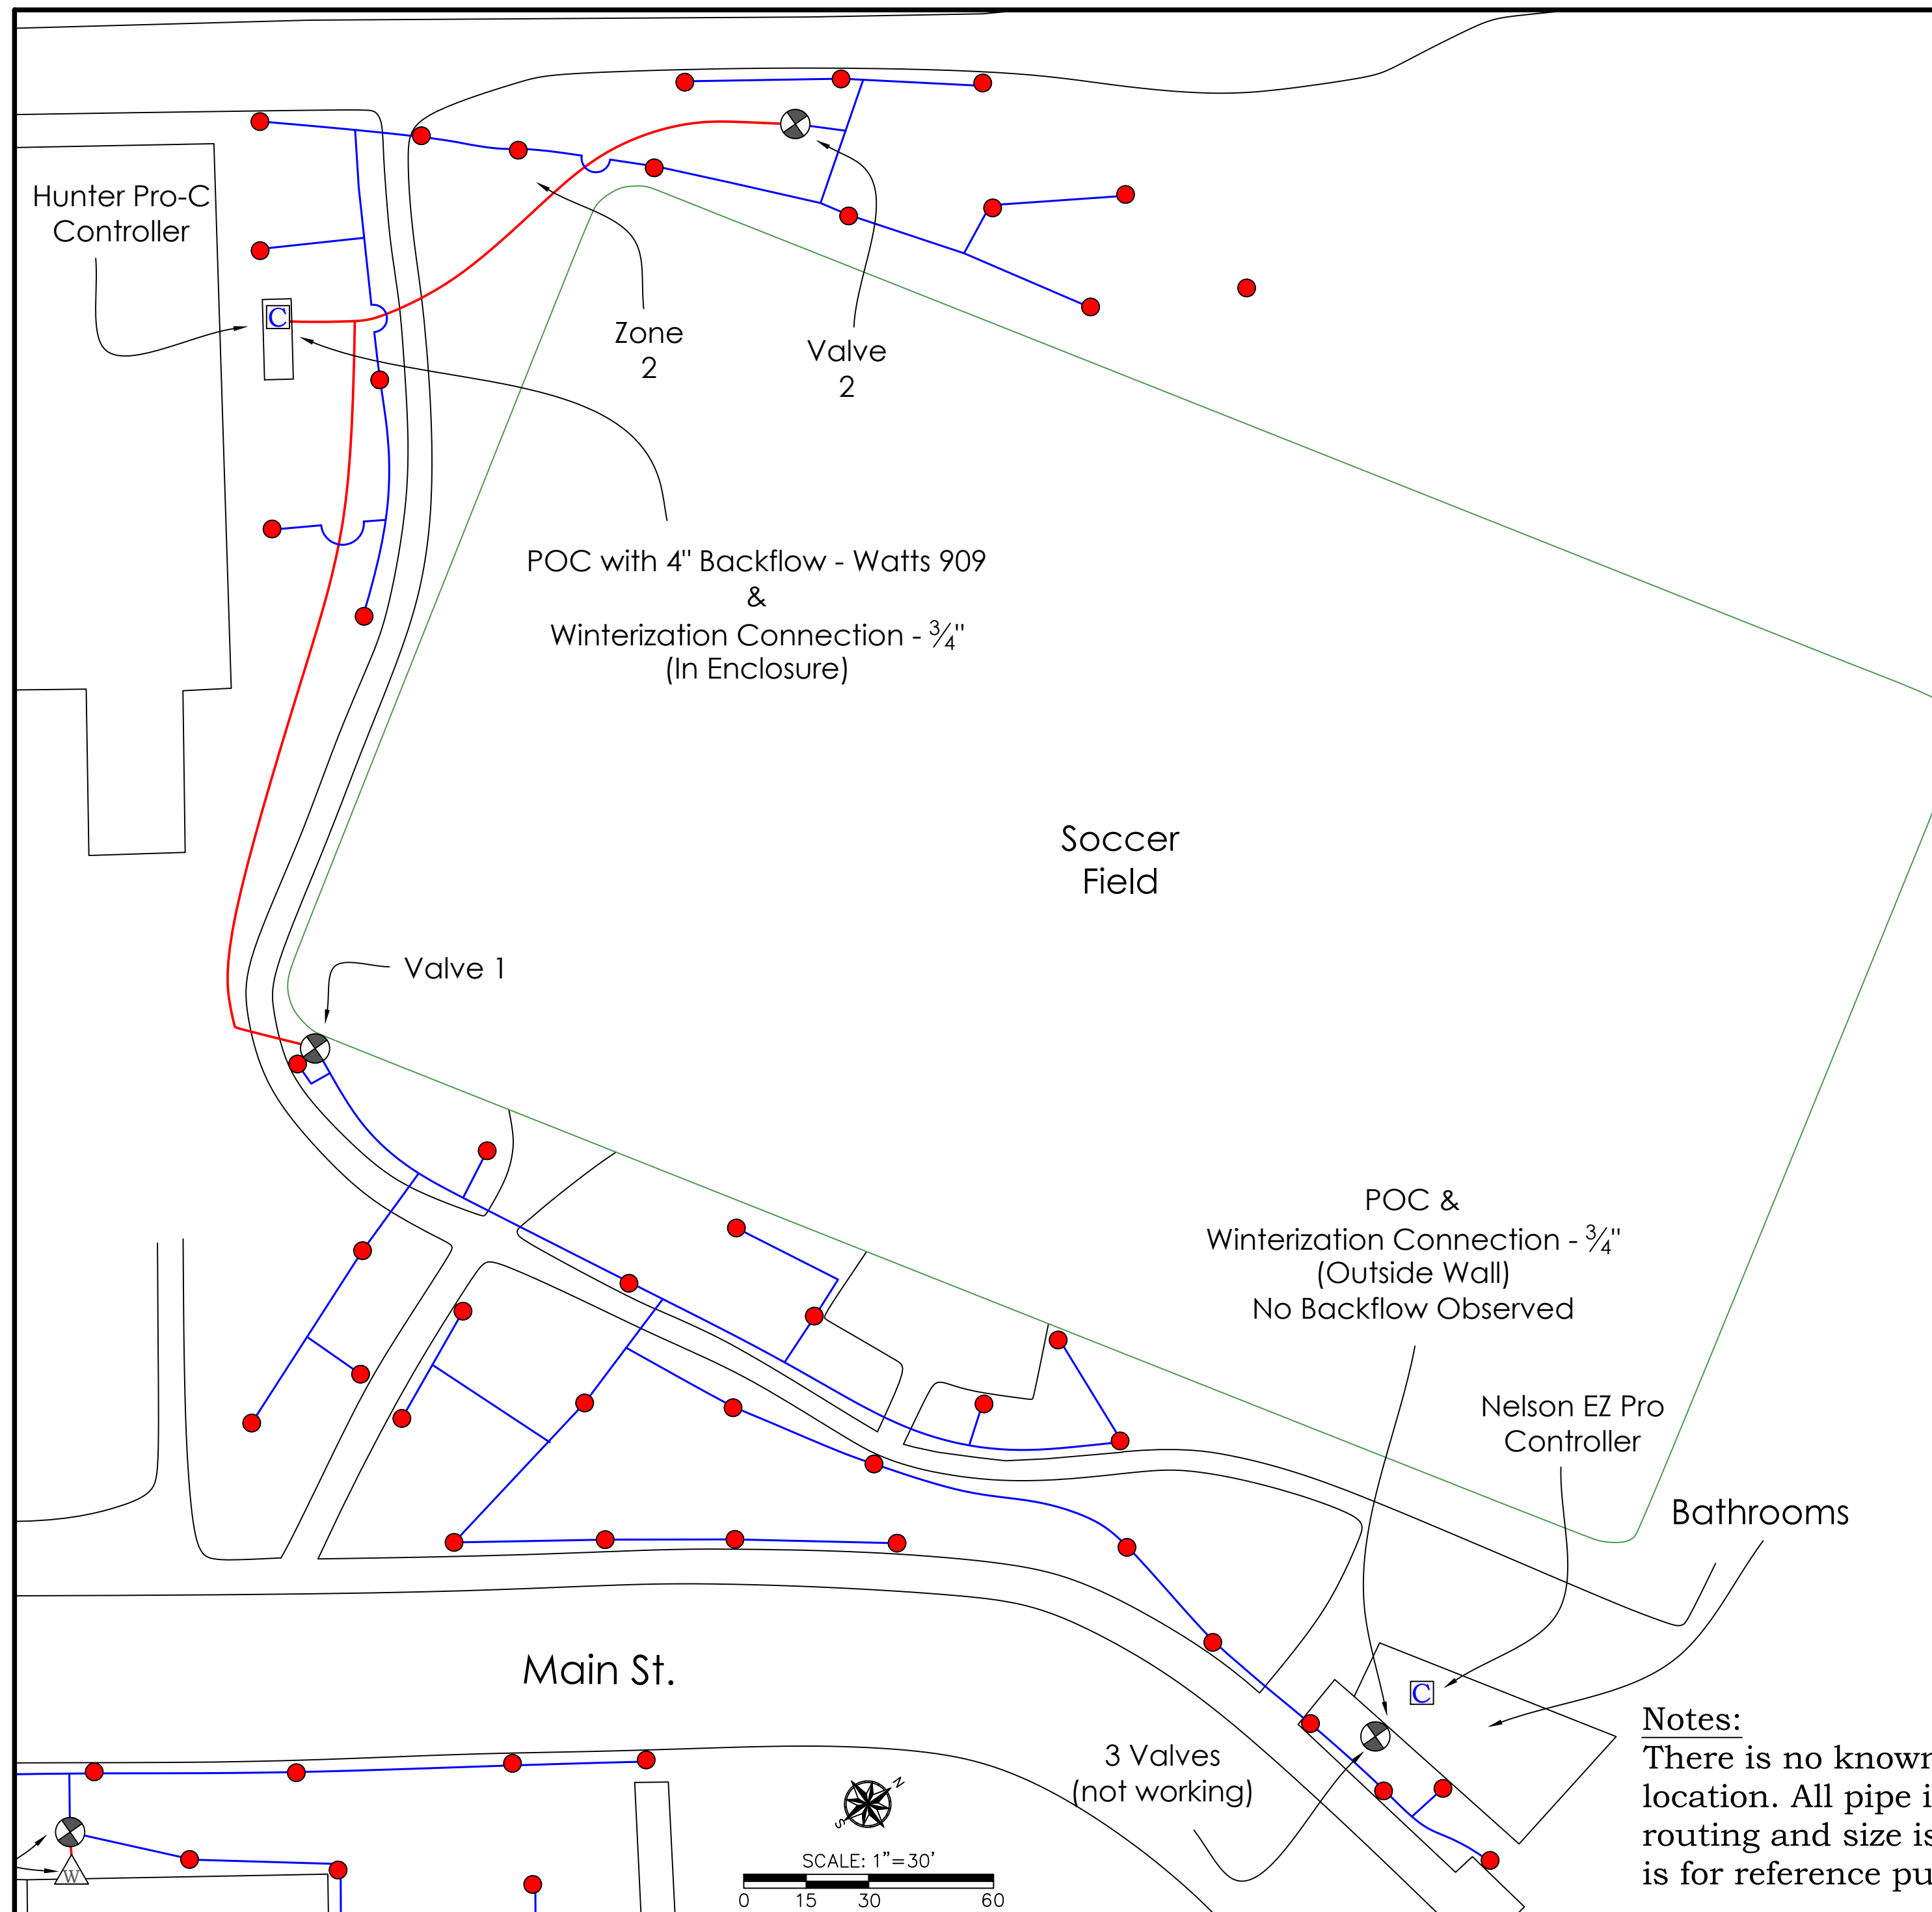

LEGEND

- Hunter Rotor Sprinkler
- ⊗ Electric Valve
- Controller - See Plan
- Mainline Pipe
- Lateral Pipe

Irrigation Assessment by:  
Smart Water Management  
Hopkinton, MA 01748  
(508) 768-5714

Irrigation Mapping by:  
Greg Albanese  
GPS New England  
Cohasset, MA 02025  
(781) 789-1166

Notes:  
There is no known asbuilt for this location. All pipe information like routing and size is unknown. Print is for reference purposes only.

**EXHIBIT A - Octagon Irrigation**